# GENERAL SPECIFICATIONS

## POWER SUPPLY

SYSTEM VOLTAGE, 3Ph+N, 440/230V,50Hz

NEUTRAL/EARTH SYSTEM:

- ☐ DIRECT TO EARTH (TT)
- ☐ ISOLATED (IT)
- ☐ EARTHED (TN-C)
- ☒ SEPARATE (TN-S)

## BUS BARS

ALUMINUM BUSBARS SUITABLY SIZED AND COLOUR CODED WITH HEAT SHRINK SLEEVES

- MAIN(VER.) ☐ ☐
- MAIN(HOR.) ☐
- NEUTRAL ☐ ☐
- BRANCH ☐ ☐
- EARTH ☐

## ENCLOSURE

FABRICATED ☒

MATERIAL
CRCA SHEET STEEL
ENCLOSURE : 2MM THICK SHEET STEEL
INT. PLATE: 2MM THICK SHEET STEEL
DOOR : 2MM THICK SHEET STEEL
GLAND PLATE : 2MM THICK
(Removable Undrilled sheet)

PRESENTATION

| | |
|---|---|
| FIXED FRONT | ☐ |
| FUNCTIONAL DOOR | ☒ |
| PLAIN DOOR | ☐ |
| TRANSPARENT DOOR | ☐ |
| OTHER | ☐ |

TYPE OF CONSTRUCTION

| | |
|---|---|
| FORM - 2 | ☒ |
| FORM - 3 | ☐ |
| FORM - 4b | ☐ |

DIMENSION
HIGHT : 1600 WIDTH : 1400 DEPTH : 350

DEGREE OF PROTECTION

- ☐ IP-54
- ☐ IP-65

| MOUNTING | INC. | OUTG. |
|---|---|---|
| ☒ FIXED | ☒ | ☒ |
| ☐ DRAW OUT | ☐ | ☐ |
| ☐ PLUG IN | ☐ | ☐ |

COLOR OF ENCLOSURE

- ☒ RAL 7035
- ☒ BLACK (For Plinth)

## CONNECTIONS

| TERMINATION | INC. | OUTG. |
|---|---|---|
| THRU BUSBAR LINKS | ☐ | ☐ |
| THRU TERMINAL BLOCKS | ☒ | ☒ |
| DIRECT THRU DEVICE | ☐ | ☐ |
| **ACCESS** | | |
| FRONT | ☒ | ☒ |
| REAR | ☐ | ☐ |
| LEFT SIDE/ RIGHT SIDE | ☐ | ☐ |
| **ENTRY** | | |
| TOP | ☐ | ☐ |
| BOTTOM | ☒ | ☒ |
| **SHROUDING** | | |
| ALL LIVE PARTS | ☒ | ☒ |

## AUXILIARIES SUPPLY

VOLTAGE

| | |
|---|---|
| 220V AC | ☐ |
| 230V AC | ☒ |
| 110V AC | ☐ |
| 24V AC | ☐ |
| 24V DC | ☐ |

ORIGIN

| | |
|---|---|
| EXTERNAL | ☐ |
| FROM BUS BAR | ☐ |
| AUXILIARY TRASFORMER | ☐ |
| FROM INCOMER | ☐ |

WIRING

| | |
|---|---|
| VOLTAGE | ☒ 1.5 Sqmm Min. |
| CURRENT | ☒ 2.5 Sqmm Min. |
| CONTROL | ☐ |

## REMARKS

### CIRCUIT MARKING

WIRING :
INTERNAL & AUXILIARY WIRING 0.5/1 Sq.mm 600/ 1000V
GRADE OF INSULATED MULTISTRAND FLEXIBLE TYPE
AND FERRULED AT ENDS AS PER WIRING DIAGRAM
ALL POWER WIRING COLOUR CODED TO RESPECTIVE PHASE
COLOURS. NEUTRAL - BLACK & EARTH - YELLOW+GREEN

230V AC Control circuit: : 1.5/2.5 Sqmm (Red / Black)

GROUND / EARTH
AC SAFETY GROUND : YELLOW/GREEN (1.5 Sqmm)

## REMARKS

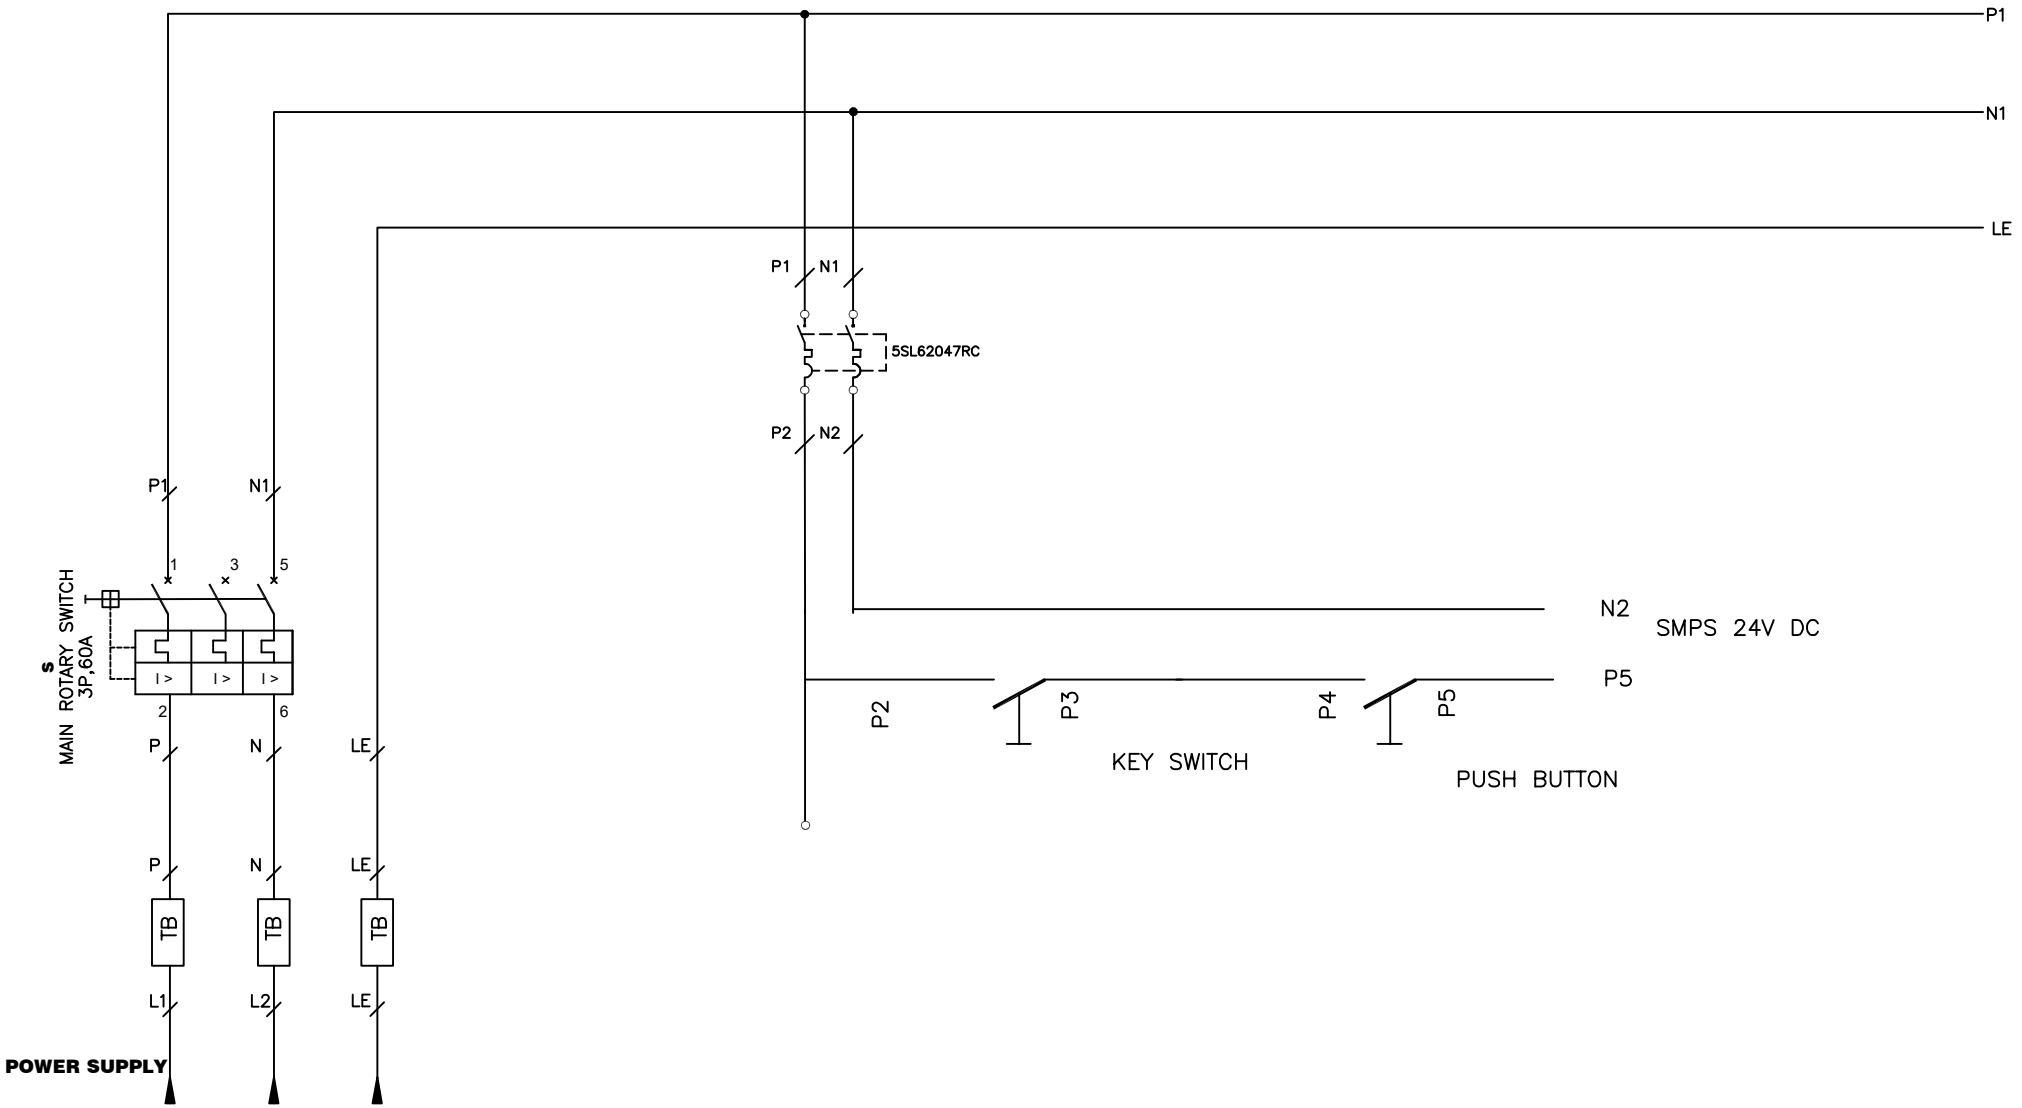
LABELS :
MFG Plates : Aluminium (Letters: White & Background: Black)
Door : Aluminium (Letters: White & Background Black)

ALL DIMENSIONS ARE IN mm

| | | | | | | | |
|---|---|---|---|---|---|---|---|
| PANEL REF : | | | | | DESIGNED : PAVAN C | DATE: 05-10-2025 | SYSTEM DESIGNED & ASSEMBLED BY: |
| PROJECT : - | | | | | DRAWN : PAVAN C : | SCALE : N.T.S | |
| R1 | | AS-BUILT | A.K | | APPROVED : GOVARDHAN | DIMENSIONS : MM | |
| R0 | 05-03-2026 | ISSUED FOR APPROVAL | A.K | CLIENT : | SHEET NO. : 1 | NO. OF SHEETS : 4 | COMPONENTS |
| REV. | DATE | DESCRIPTION | REV. BY | JOB NO. : | DWG. NO : 01 | | KINCO |


# POWER CONNECTION

TO NEXT PAGE





| | | | | | | | |
|---|---|---|---|---|---|---|---|
| PANEL REF : | | | | | DESIGNED : PAVAN C | DATE: 05-03-2026 | SYSTEM DESIGNED & ASSEMBLED BY: |
| PROJECT : - | | | | | DRAWN : PAVAN C : | SCALE : N.T.S | |
| R1 | 05-03-2026 | AS-BUILT | A.K | | APPROVED : GOVARDHAN | DIMENSIONS : MM | |
| R0 | | ISSUED FOR APPROVAL | A.K | CLIENT : | SHEET NO. : 2 | NO. OF SHEETS : 5 | COMPONENTS |
| REV. | DATE | DESCRIPTION | REV. BY | JOB NO. : | DWG. NO : 01 | | KINCO |

# SMPS TO FUSE CONNECTION

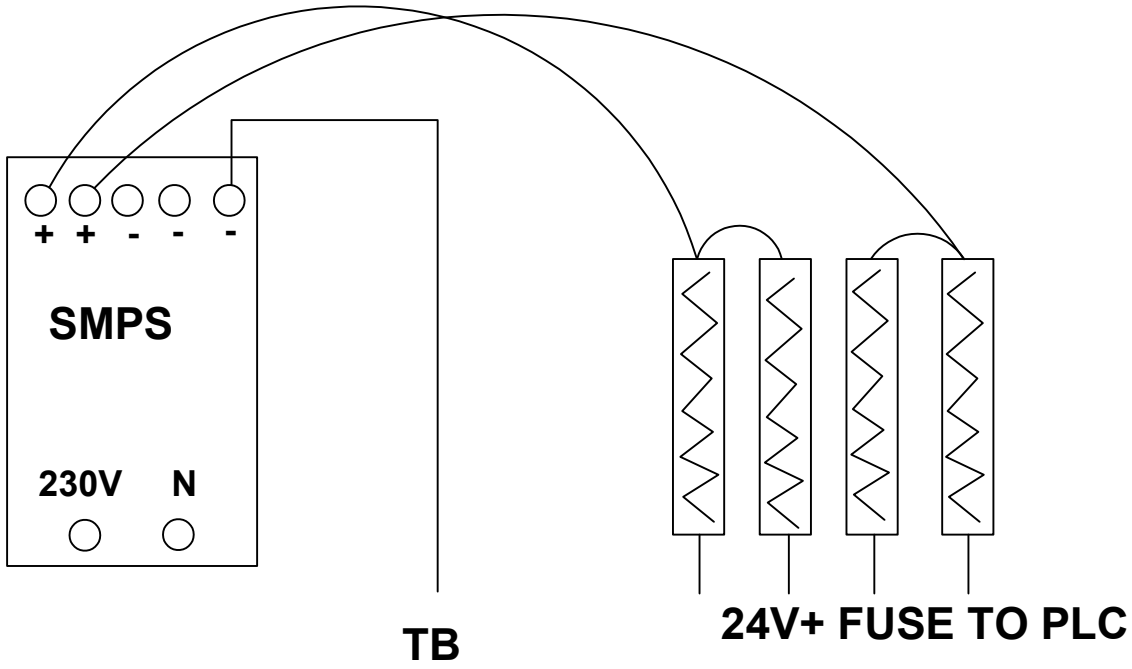



| | | | | | | | |
|---|---|---|---|---|---|---|---|
| PANEL REF : | | | | | DESIGNED : PAVAN C | DATE: | SYSTEM DESIGNED & ASSEMBLED BY: |
| PROJECT : - | | | | | DRAWN : PAVAN C : | SCALE : N.T.S | |
| R1 | | AS-BUILT | A.K | | APPROVED : GOVARDHAN | DIMENSIONS : MM | |
| R0 | | ISSUED FOR APPROVAL | A.K | CLIENT : | SHEET NO. : 3 | NO. OF SHEETS : 5 | COMPONENTS |
| REV. | DATE | DESCRIPTION | REV. BY | JOB NO. : | DWG. NO : 01 | | KINCO |

# PLC CONNECTION

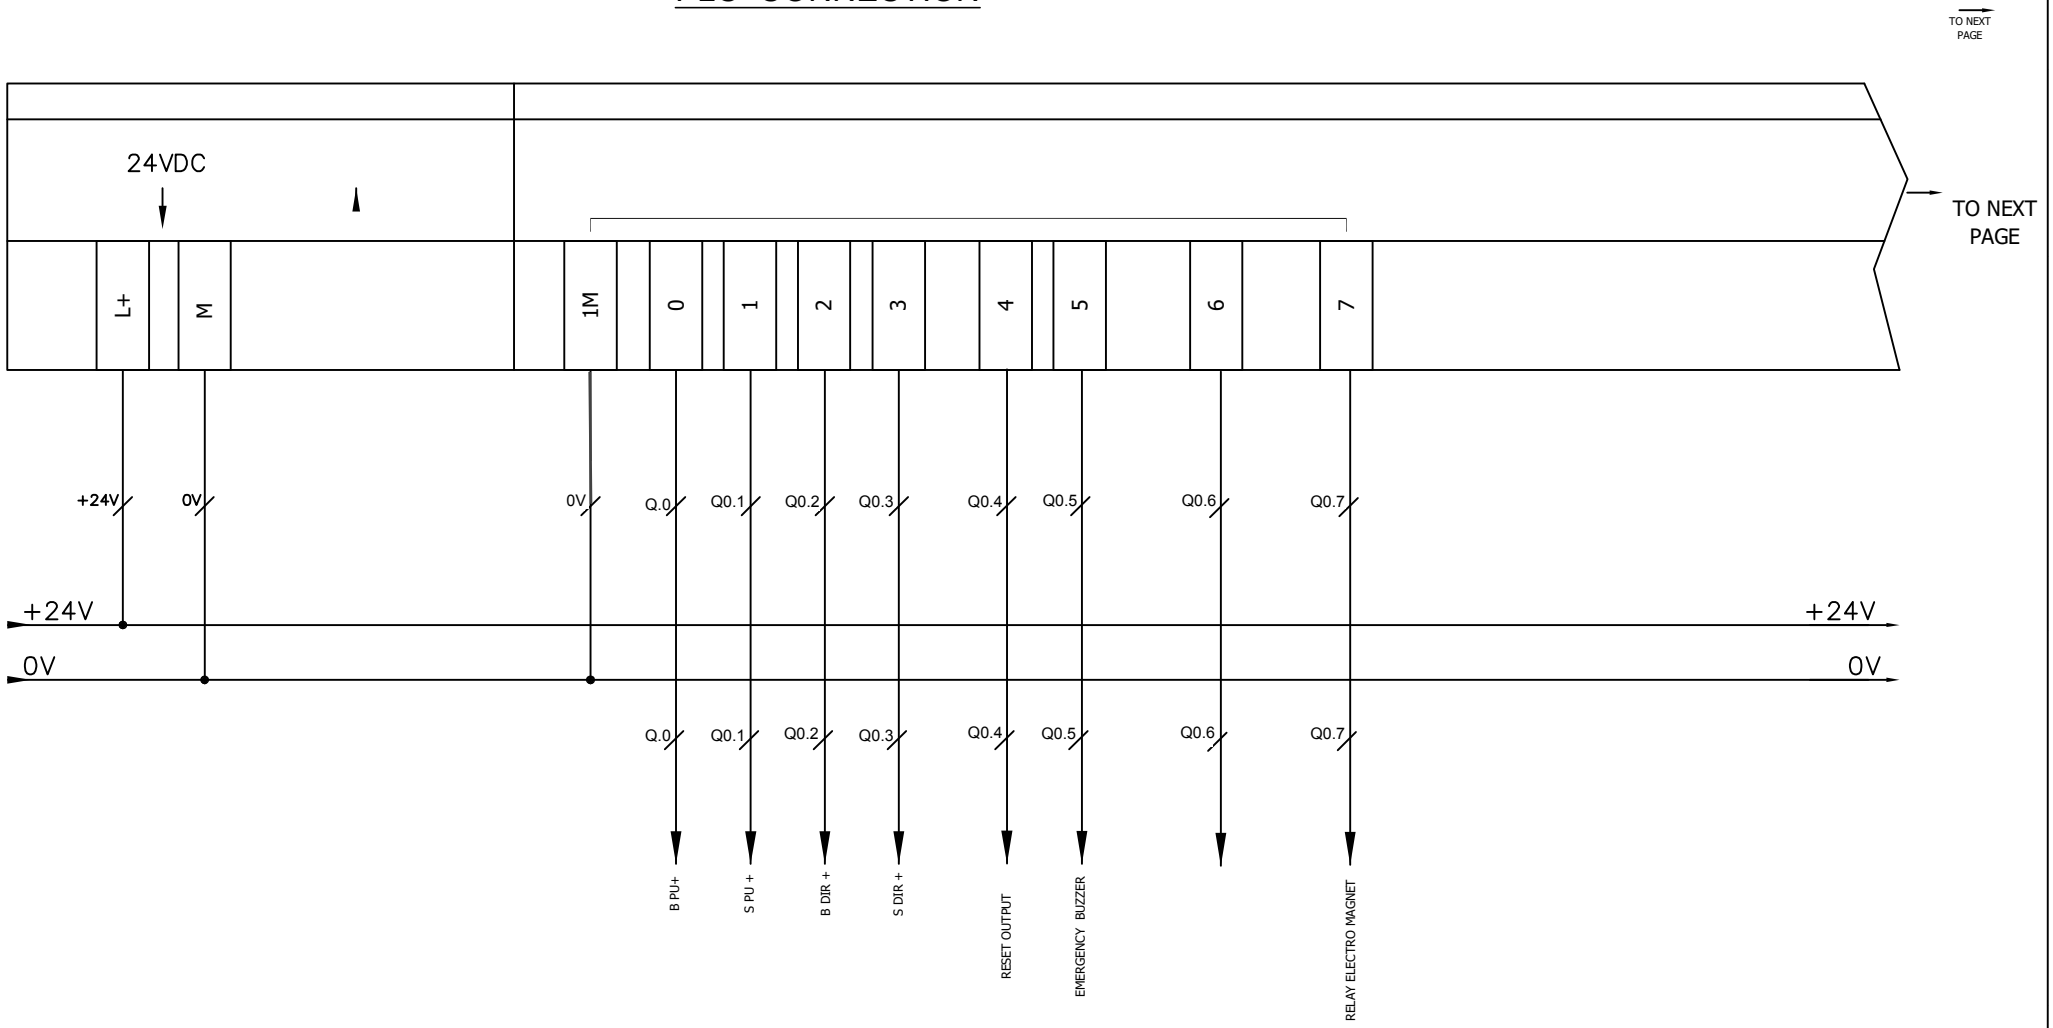


| | | | | | | | |
|---|---|---|---|---|---|---|---|
| PANEL REF : | | | | | DESIGNED : PAVAN C | DATE: 26-09-2025 | SYSTEM DESIGNED & ASSEMBLED BY: |
| PROJECT : - | | | | | DRAWN : PAVAN C : | SCALE : N.T.S | |
| R1 | | AS-BUILT | A.K | | APPROVED : GOVARDHAN | DIMENSIONS : MM | |
| R0 | | ISSUED FOR APPROVAL | A.K | CLIENT : | SHEET NO. : 3 | NO. OF SHEETS : 5 | COMPONENTS |
| REV. | DATE | DESCRIPTION | REV. BY | JOB NO. : | DWG. NO : 01 | | KINCO |

# PLC CONNECTION

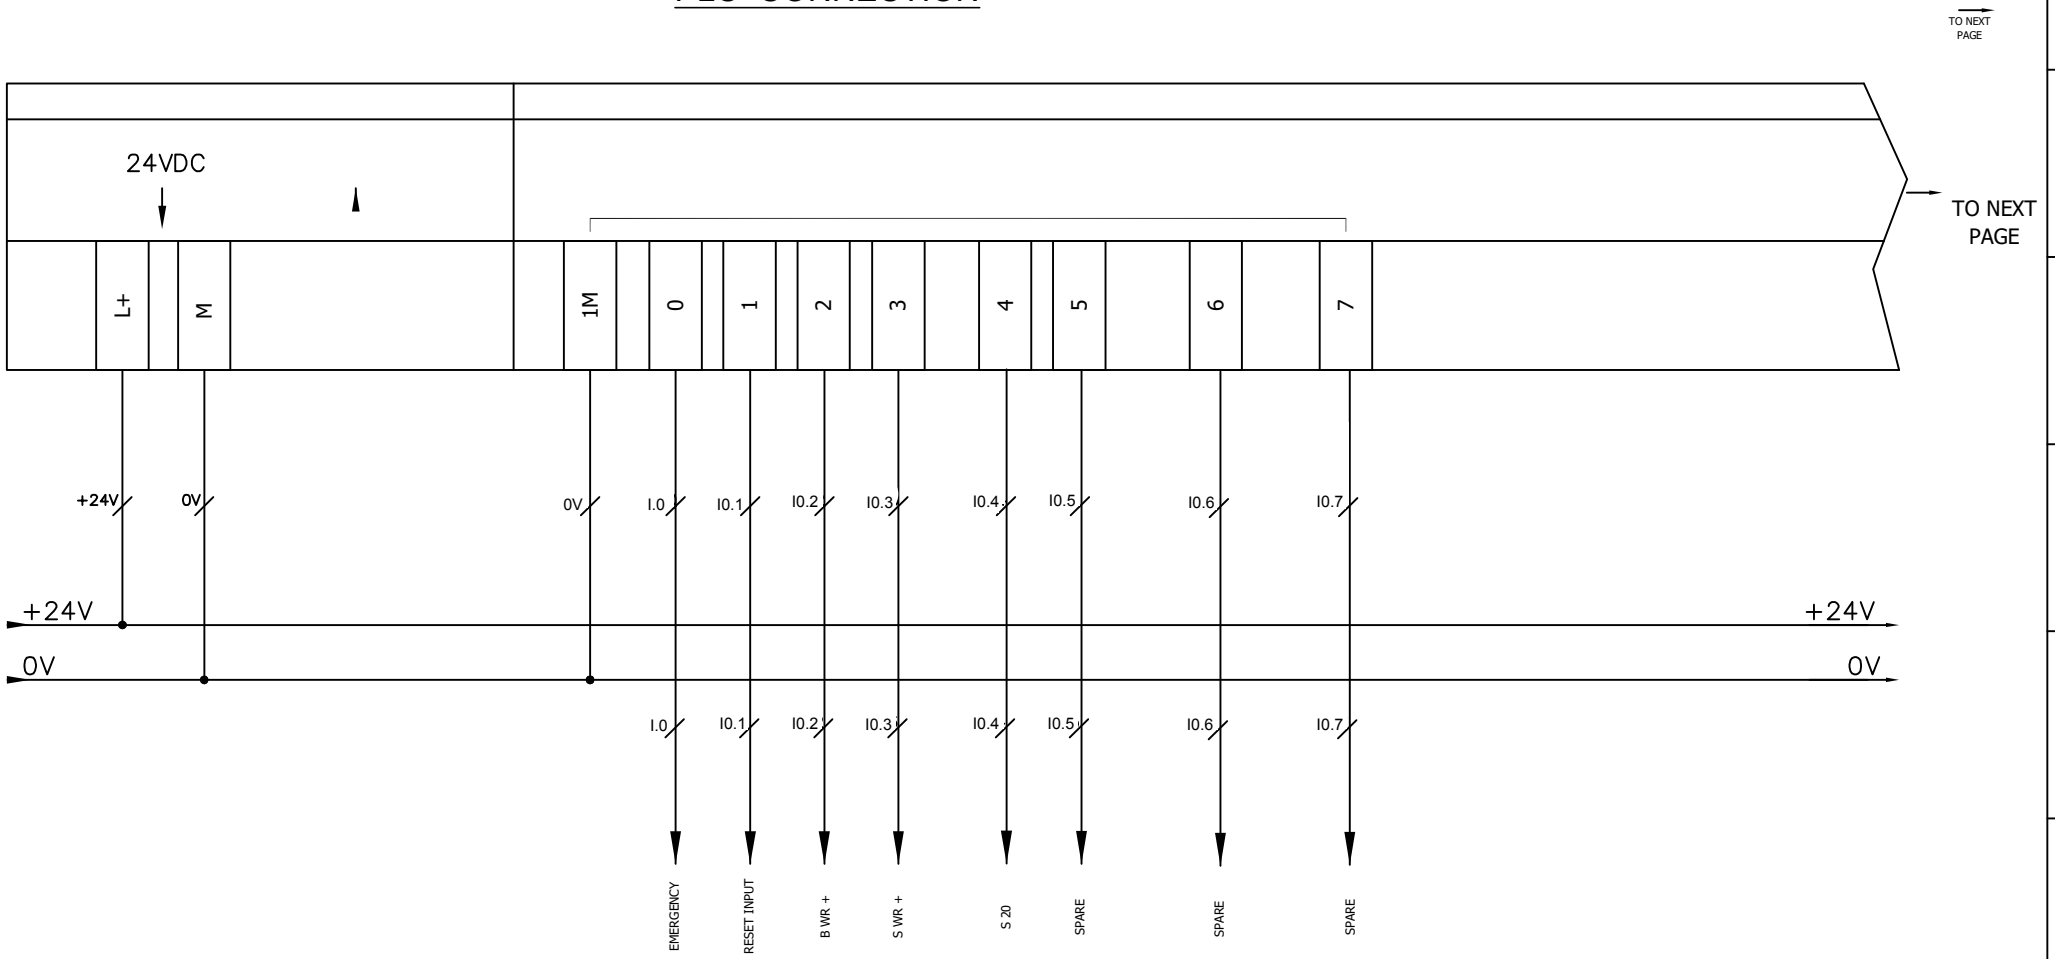


| | | | | | | | |
|---|---|---|---|---|---|---|---|
| PANEL REF : | | | | | DESIGNED : PAVAN C | DATE: 26-09-2025 | SYSTEM DESIGNED & ASSEMBLED BY: |
| PROJECT : - | | | | | DRAWN : PAVAN C : | SCALE : N.T.S | |
| R1 | | AS-BUILT | A.K | | APPROVED : GOVARDHAN | DIMENSIONS : MM | |
| R0 | | ISSUED FOR APPROVAL | A.K | CLIENT : | SHEET NO. : 5 | NO. OF SHEETS : 5 | COMPONENTS |
| REV. | DATE | DESCRIPTION | REV. BY | JOB NO. : | DWG. NO : 01 | | KINCO |